
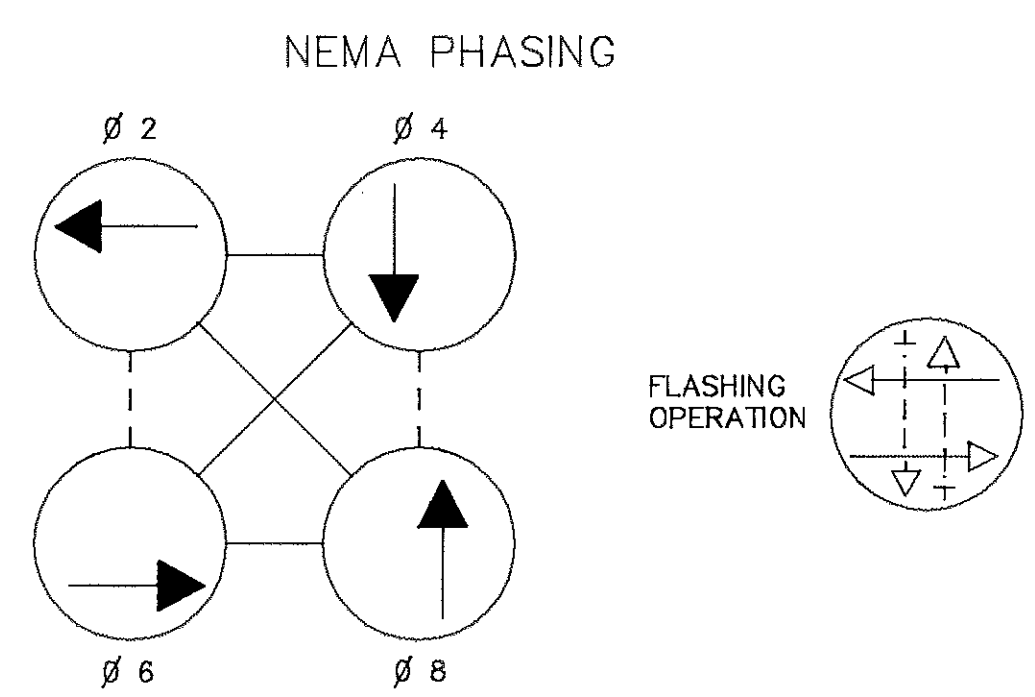
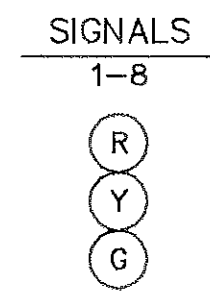


F H WA REGION NO	STATE	FED. AID PROJ. NO	SHEET NO.	TOTAL SHEETS
3	MD.	CMG-5019(6)E	11	26

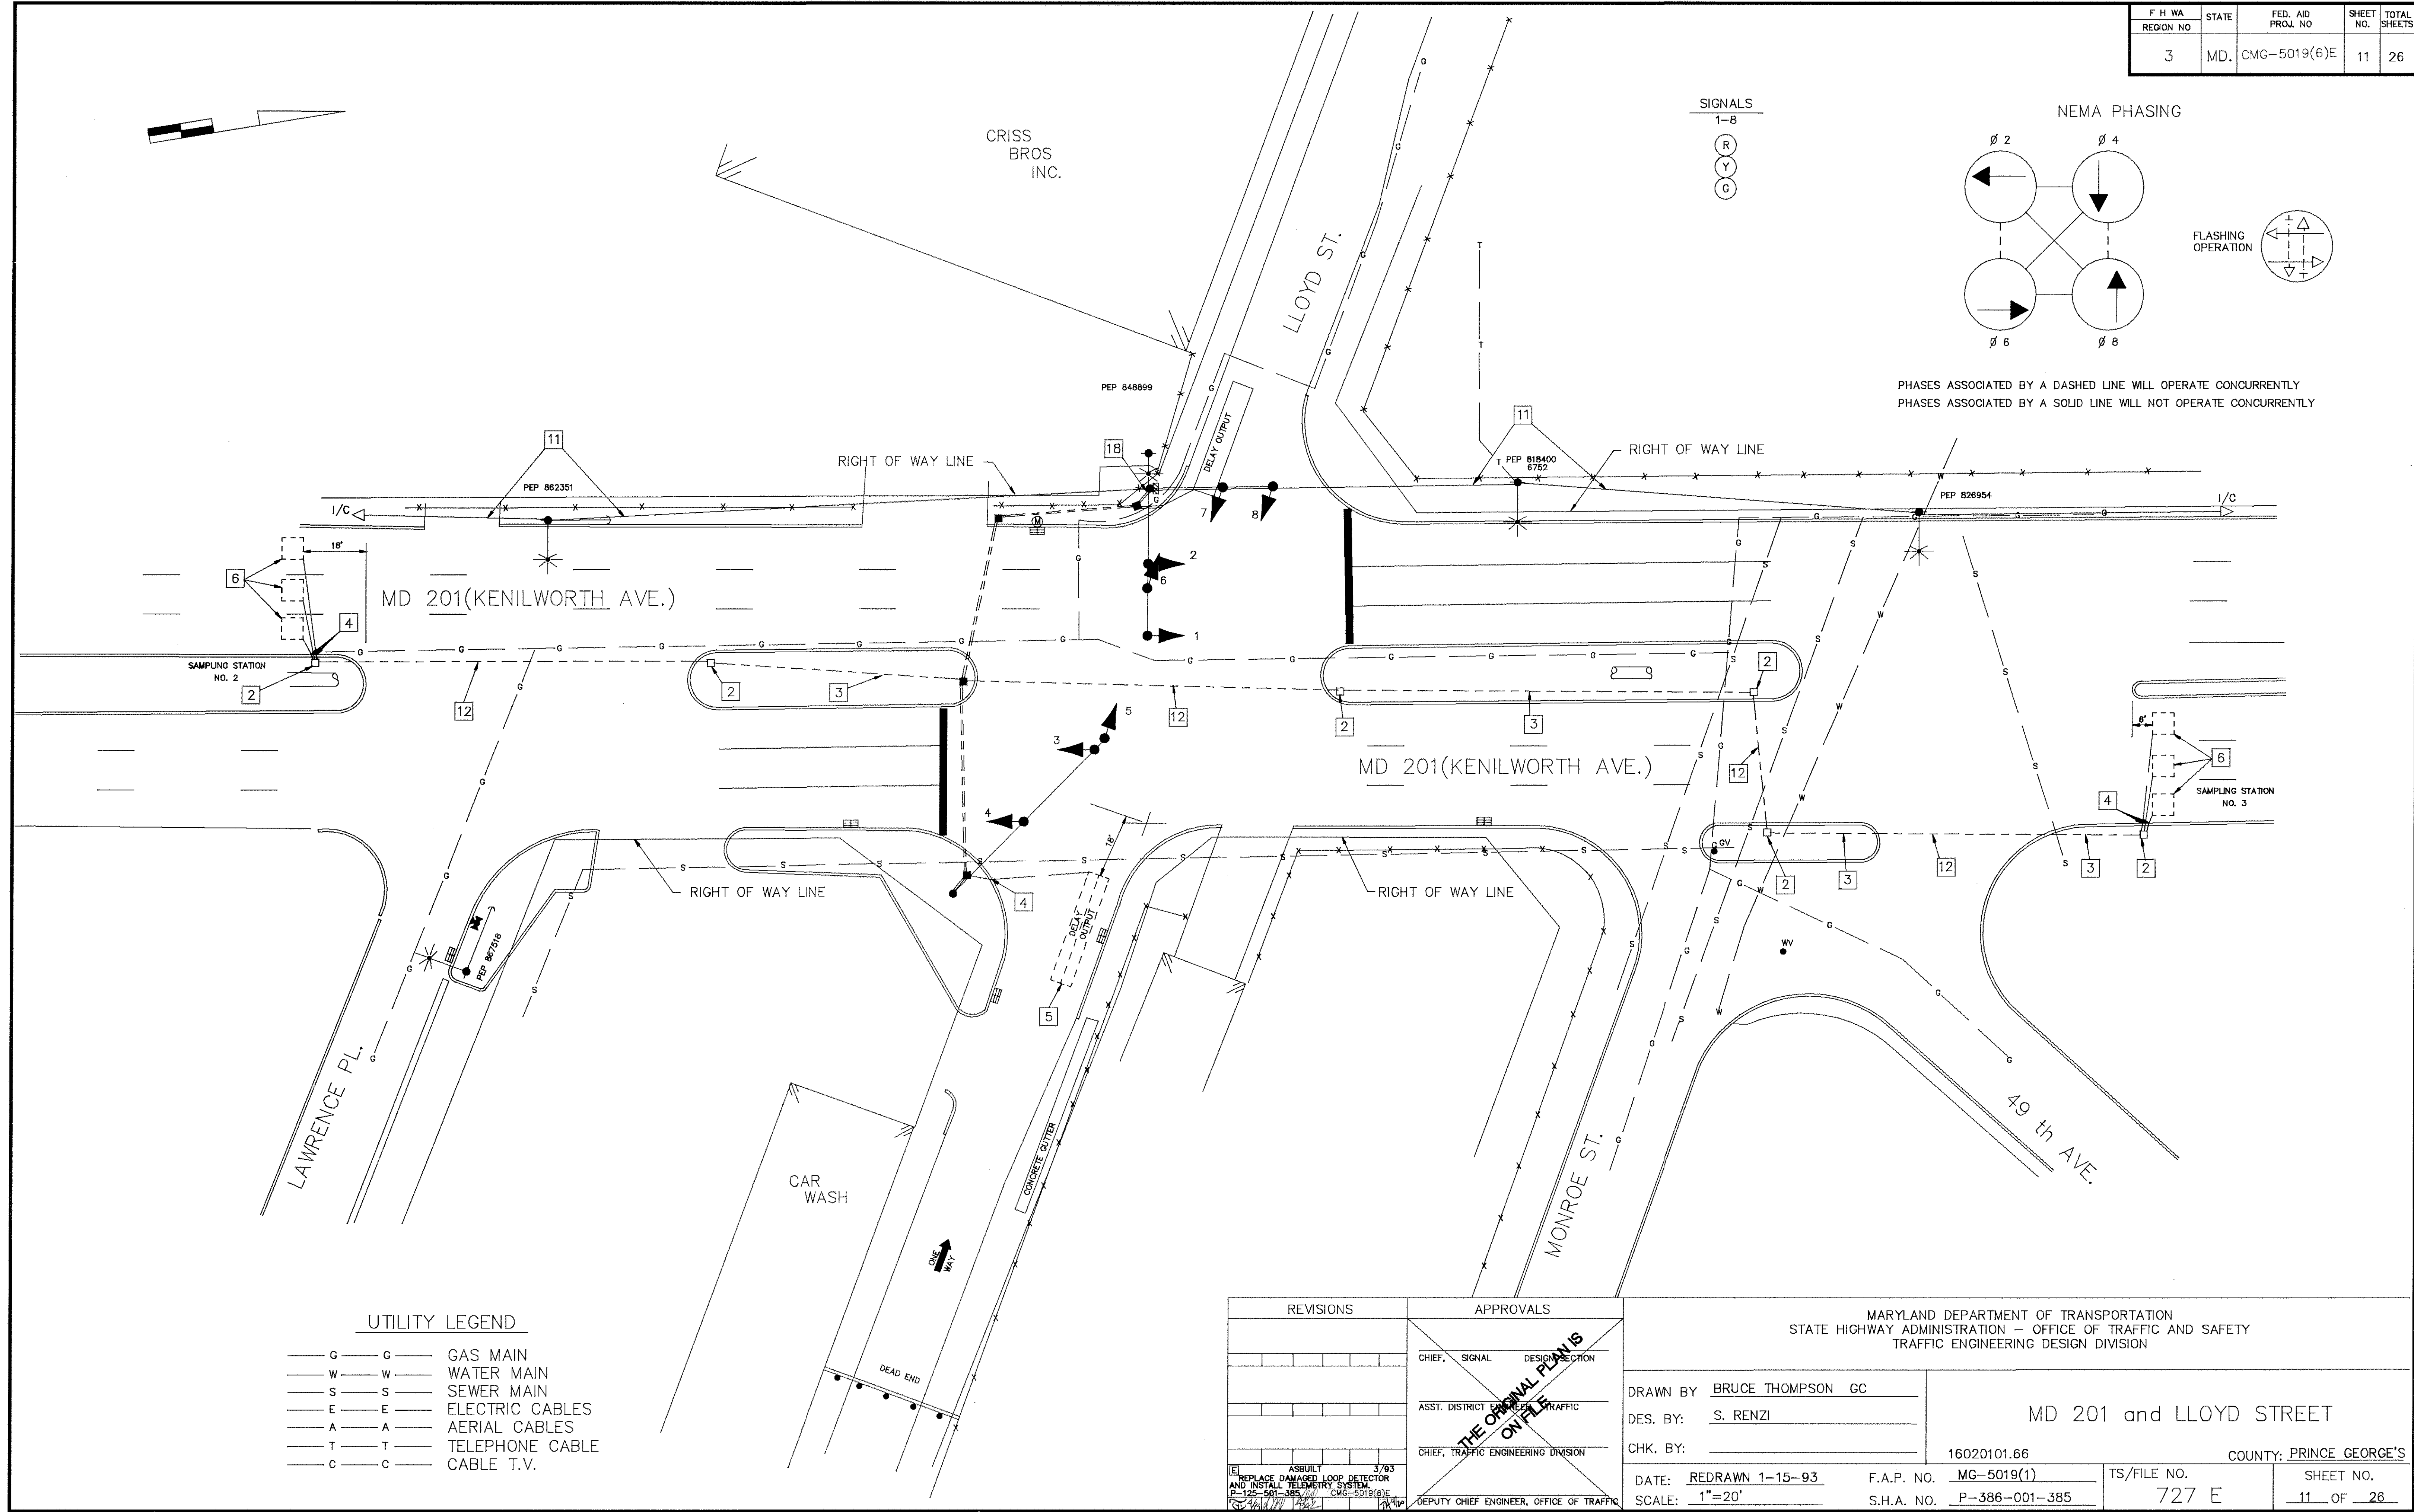

PHASES ASSOCIATED BY A DASHED LINE WILL OPERATE CONCURRENTLY
PHASES ASSOCIATED BY A SOLID LINE WILL NOT OPERATE CONCURRENTLY

UTILITY LEGEND

- G — G — GAS MAIN
- W — W — WATER MAIN
- S — S — SEWER MAIN
- E — E — ELECTRIC CABLES
- A — A — AERIAL CABLES
- T — T — TELEPHONE CABLE
- C — C — CABLE T.V.

<p>REVISIONS</p> <table border="1"> <tr><td> </td><td> </td></tr> <tr><td> </td><td> </td></tr> <tr><td> </td><td> </td></tr> <tr><td> </td><td> </td></tr> <tr><td> </td><td> </td></tr> <tr><td> </td><td> </td></tr> </table>														<p>APPROVALS</p> <p>CHIEF, SIGNAL DESIGN SECTION</p> <p>ASST. DISTRICT ENGINEER, TRAFFIC</p> <p>CHIEF, TRAFFIC ENGINEERING DIVISION</p>		<p>MARYLAND DEPARTMENT OF TRANSPORTATION STATE HIGHWAY ADMINISTRATION - OFFICE OF TRAFFIC AND SAFETY TRAFFIC ENGINEERING DESIGN DIVISION</p>			
<p>DATE: REDRAWN 1-15-93</p> <p>SCALE: 1"=20'</p>		<p>DRAWN BY: BRUCE THOMPSON GC</p> <p>DES. BY: S. RENZI</p> <p>CHK. BY: _____</p>		<p>MD 201 and LLOYD STREET</p> <p>16020101.66</p> <p>COUNTY: PRINCE GEORGE'S</p>															
<p>ASBUILT 3/93 REPLACE DAMAGED LOOP DETECTOR AND INSTALL TELEMETRY SYSTEM P-125-501-385 CMG-5019(6)E</p>		<p>DEPUTY CHIEF ENGINEER, OFFICE OF TRAFFIC</p>		<p>TS/FILE NO. 727 E</p> <p>SHEET NO. 11 OF 28</p>															

16020101.66

F# 46